



CITY OF ALBANY  
Public Works Department

ADDENDUM #1

WTP-18-01  
VINE STREET WTP ACCELATOR IMPROVEMENTS

In order to clarify the intent of the Specifications and Drawings, the following provisions are provided and shall be considered part of the contract documents.

In order to ensure that all bidders are aware of these provisions, each bidder shall sign this addendum below and attach it to the proposal.

**IMPORTANT: Failure to include a signed Addendum could result in the disqualification of your bid.**

**BID OPENING DATE AND TIME AND LOCATION:**

The bid opening has been rescheduled for **Thursday, May 9, 2019, at 2:00 p.m.** The location has been changed from the **Calapooia Room to the Periwinkle Room** at City Hall, 333 Broadalbin Street SW, Albany, OR 97321. Dropoff location for bids is unchanged.

**CONSTRUCTION DRAWINGS:**

Sheet G03 was amended to clarify some dimensions.

Drawing G06: The inside of the cone shall be prepared and coated. All surfaces above the deck plate as shown in the attached shop drawing 90524-02-002 shall be coated.

**TECHNICAL SPECIFICATIONS:**

Specification 0990 2.04, E.1.b.- The Contractor may submit using SSPC SP-6 for exterior surface preparation on Accelator No. 2 provided this is acceptable to the coating supplier. Any additional material or preparation required by the supplier shall be at no additional cost to the City.

Specification 09900 2.01,A.1.a.2)- Change Carboguard 691 to Carboguard 891VOC.

Specification 09900 2.01,B.2.a.2)- Change Flexxide Elastomer to Sanitile 120 Bonding Primer applied at 2.0 to 4.0 mils DFT followed by Flexxide Elastomer.

**THE FOLLOWING ITEMS ARE CLARIFICATIONS BASED ON QUESTIONS RECEIVED:**

The fence on the south side of Accelator No. 1 has removable sections between the posts. The Contractor may remove these sections while working on the exterior of the tank but must replace the sections during non-working hours. If the Contractor has an alternative method to secure the site, the Contractor may submit a plan for approval.

\_\_\_\_\_  
Contractor's Signature

\_\_\_\_\_  
Date

\_\_\_\_\_  
Company Name *(please type or print)*



NOTICE TO CONTRACTORS  
CITY OF ALBANY  
**INVITATION TO BID**  
See Addendum No. 1

Category of Bid: Construction  
Engineer's Estimate: \$810,000  
Bids due at 2:00 p.m., ~~Tuesday, May 7, 2019~~ **Thursday, May 9, 2019**

The City of Albany hereby extends an invitation to submit bids for:

**WTP-18-01, Vine Street WTP Accelerator Improvements.** This project will replace the existing tube settlers, clean and recoat the steel plate surfaces, and repair and coat concrete surfaces on the Accelerators. The existing bridge and catwalk in Accelerator 1 will be replaced, and an existing eight-inch valve will be replaced on Accelerator 2.

**An optional prebid meeting will be onsite at 300 Vine SW, Wednesday, May 1, 2019, at 10:30 AM.**

Bids submitted shall be filed in sealed envelopes and received at the City of Albany Parks & Recreation counter, not later than 2:00 p.m., ~~Tuesday, May 7, 2019~~ **Thursday, May 9, 2019**, addressed to the attention of Diane Murzynski, Purchasing Coordinator, at Albany City Hall, Finance Department, 333 Broadalbin Street SW, Albany, OR 97321. The outside of the envelopes shall plainly identify: (1) the Project name, (2) the Bid Opening time and date, (3) the Bidder's name, and (4) the Contractor's license number (per ORS 701). Immediately following the filing deadline, the bids shall be opened and publicly read in the Santiam Room of City Hall. Bid totals will be posted on the City's website at <http://www.cityofalbany.net/departments/finance/city-purchasing/bids-rfps-rfq.s>.

Contract bid documents may be examined at the Office of the Public Works Director, City Hall, 333 Broadalbin Street SW, Albany, Oregon, 541-917-7676; downloaded from the City of Albany website at <http://www.cityofalbany.net/departments/finance/city-purchasing/bids-rfps-rfq.s>; or a printed set may be purchased for \$35. It is imperative those who download the contract bid documents check the website regularly for addenda, clarifications, and other pertinent notifications. All who are known by the City of Albany to have received a complete set of the contract bid documents will receive notification when additional items are posted. Please call 541-917-7676 to be added to the Plan Holder's list.

Each bidder must have access to a current set of City of Albany *Standard Construction Specifications*, which can be found on the City's website at <http://www.cityofalbany.net/departments/public-works/engineering/standard-construction-specifications> or a printed set may be purchased for \$100. All public improvements are required to conform to these specifications and bid prices shall reflect these specifications. For project information, call Nolan Nelson at 541-791-0130.

All City contracts contain a statement declaring that the bidder agrees to comply with the provisions of ORS 279C.800 through 279C.870 regarding payment of prevailing wages. The City's contract contains a clause which incorporates by reference all of the provisions of ORS Chapter 279C which are applicable to public contracts. Bidders are expected to be familiar with these provisions including, but not limited to, recent changes to ORS Chapter 279C.

**No bid shall be received or considered unless the bidder is licensed by the Construction Contractors Board for construction projects or licensed with the State Landscape Contractors Board for landscaping projects.**


A 10% bid bond, certified check, or cashier's check shall accompany each bid on all projects and shall be forfeited if the bidder fails to enter into a Contract with the City of Albany within ten (10) days after the date of the Notice of Award.

DATED this 22nd day of April 2019.

Diane M. Murzynski, CPPO, CPPB  
Purchasing Coordinator

PUBLISH: Daily Journal of Commerce, on Monday, April 22, 2019  
Albany Democrat-Herald, on Monday, April 22, 2019

P:\Clients\519 City of Albany\18-17-17 Vine WTP Accelerator\CAD\Production\51918-1717-G03-G04.dwg 4/30/2019 9:26 AM sbarber


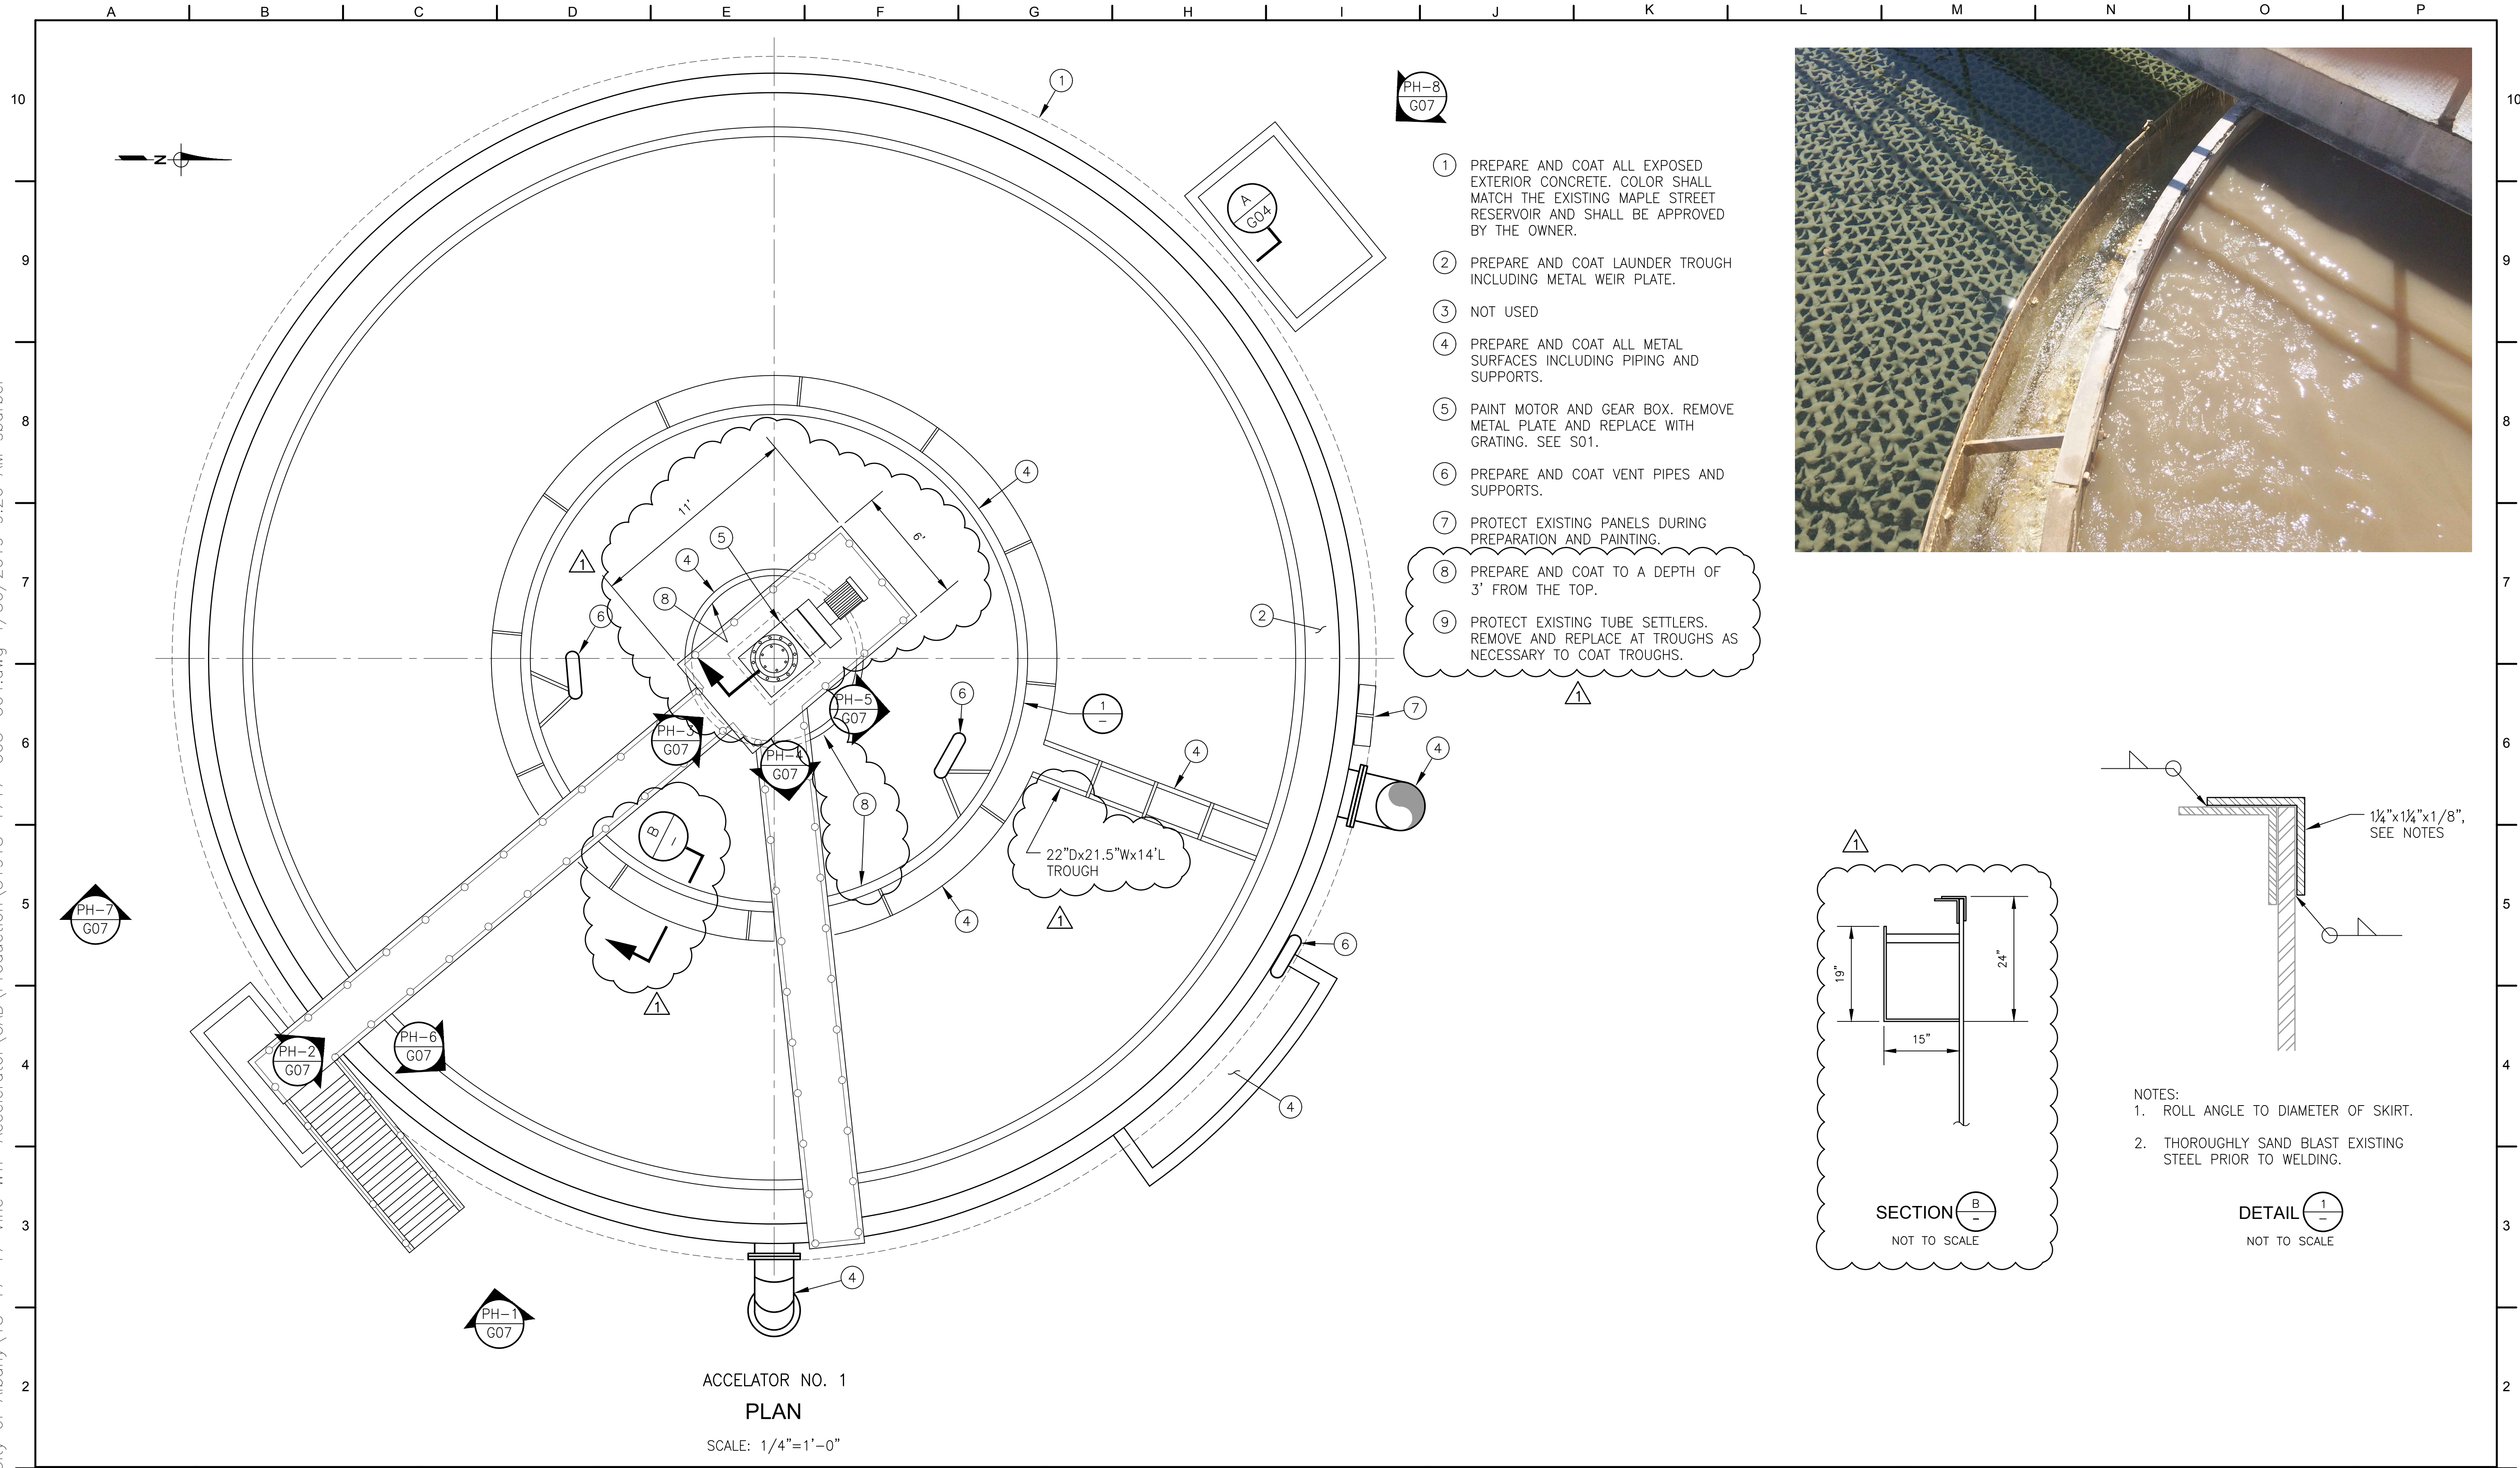


PH-8  
G07

- 1 PREPARE AND COAT ALL EXPOSED EXTERIOR CONCRETE. COLOR SHALL MATCH THE EXISTING MAPLE STREET RESERVOIR AND SHALL BE APPROVED BY THE OWNER.
- 2 PREPARE AND COAT LAUNDER TROUGH INCLUDING METAL WEIR PLATE.
- 3 NOT USED
- 4 PREPARE AND COAT ALL METAL SURFACES INCLUDING PIPING AND SUPPORTS.
- 5 PAINT MOTOR AND GEAR BOX. REMOVE METAL PLATE AND REPLACE WITH GRATING. SEE S01.
- 6 PREPARE AND COAT VENT PIPES AND SUPPORTS.
- 7 PROTECT EXISTING PANELS DURING PREPARATION AND PAINTING.
- 8 PREPARE AND COAT TO A DEPTH OF 3' FROM THE TOP.
- 9 PROTECT EXISTING TUBE SETTLERS. REMOVE AND REPLACE AT TROUGHS AS NECESSARY TO COAT TROUGHS.




22"Dx21.5"Wx14"L  
TROUGH

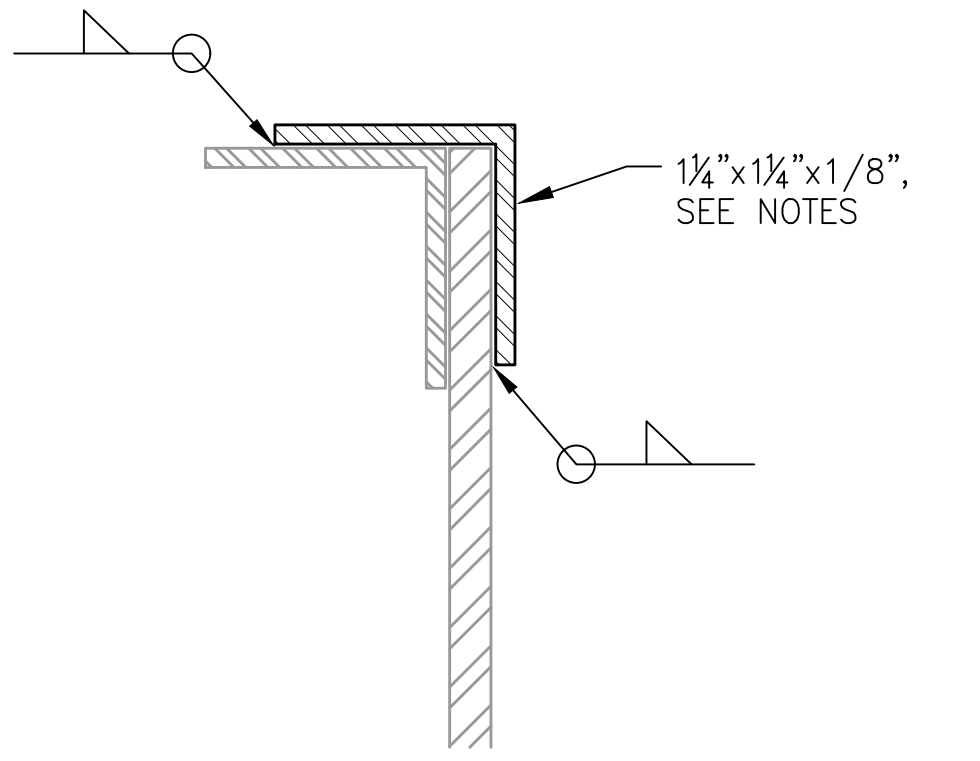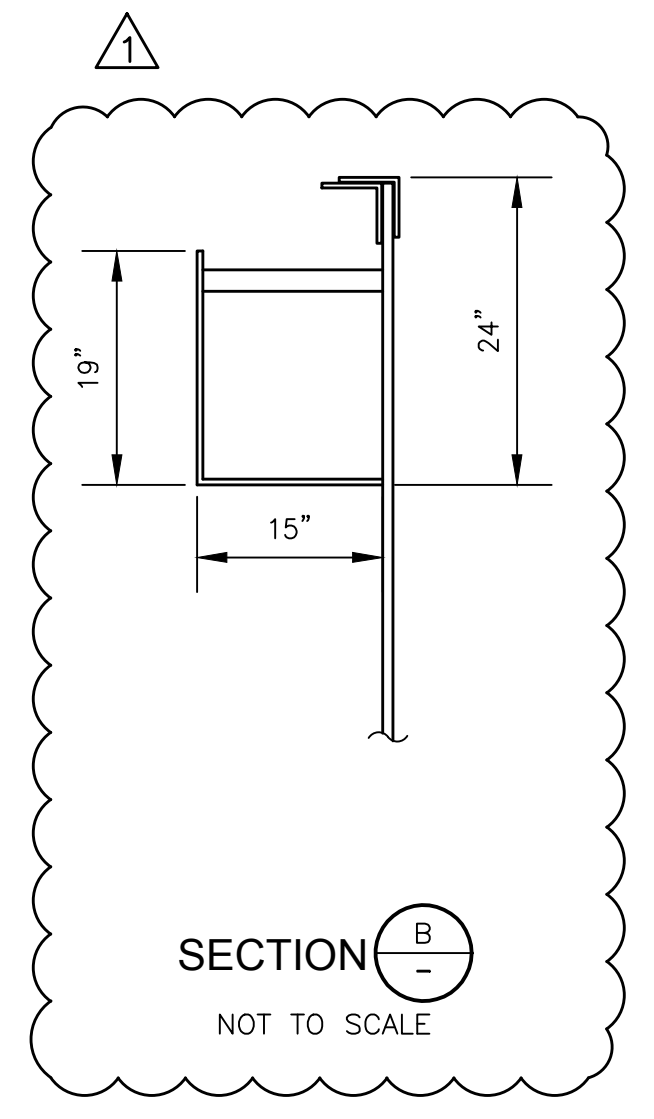

- NOTES:
1. ROLL ANGLE TO DIAMETER OF SKIRT.
  2. THOROUGHLY SAND BLAST EXISTING STEEL PRIOR TO WELDING.

ACCELERATOR NO. 1  
PLAN  
SCALE: 1/4"=1'-0"

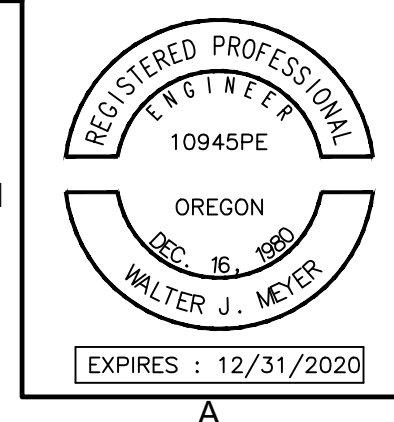

QC REVIEW: \_\_\_\_\_  
DATE: \_\_\_\_\_

THIS LINE IS 1 INCH  
AT FULL SCALE  
IF NOT SCALE ACCORDINGLY


SCALE : 1/4"=1'-0"

DRAWN BY : SMB  
DESIGNED BY : XXX  
PROJ. MGR. : WJM

No.	ZONE	REVISIONS	BY	DATE

**WEST YOST ASSOCIATES**


4949 Meadows Road  
Suite 125  
Lake Oswego, Oregon 97035  
(503) 451-4500  
FAX (503) 756-4991

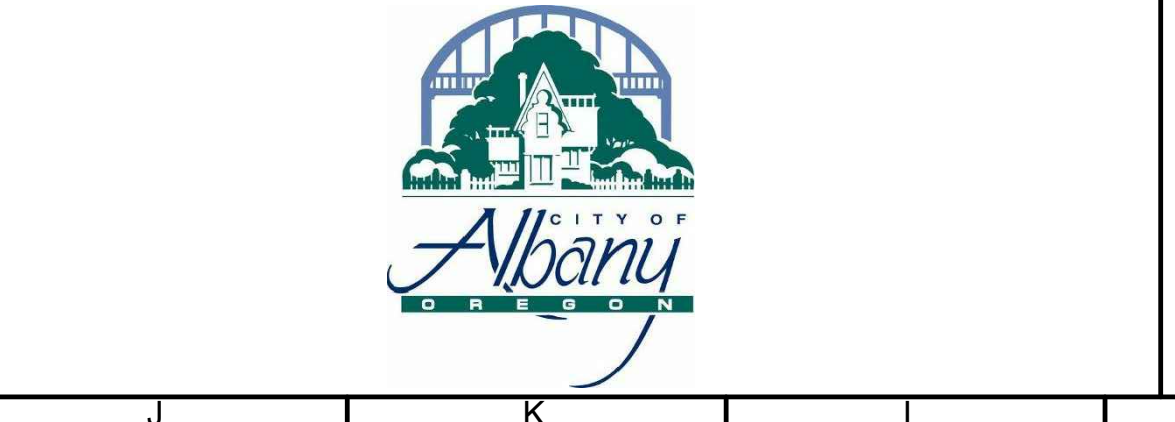


**CITY OF ALBANY**  
**VINE STREET WTP ACCELERATOR IMPROVEMENTS**  
**ACCELERATOR NO. 1**  
**PLAN**

JOB NUMBER 519-18-17-17
DRAWING NUMBER <b>G03</b>
SHEET NUMBER <b>3</b> OF <b>14</b>
REVISION

SEE DWG D90524-02-001 FOR GENERAL NOTES.

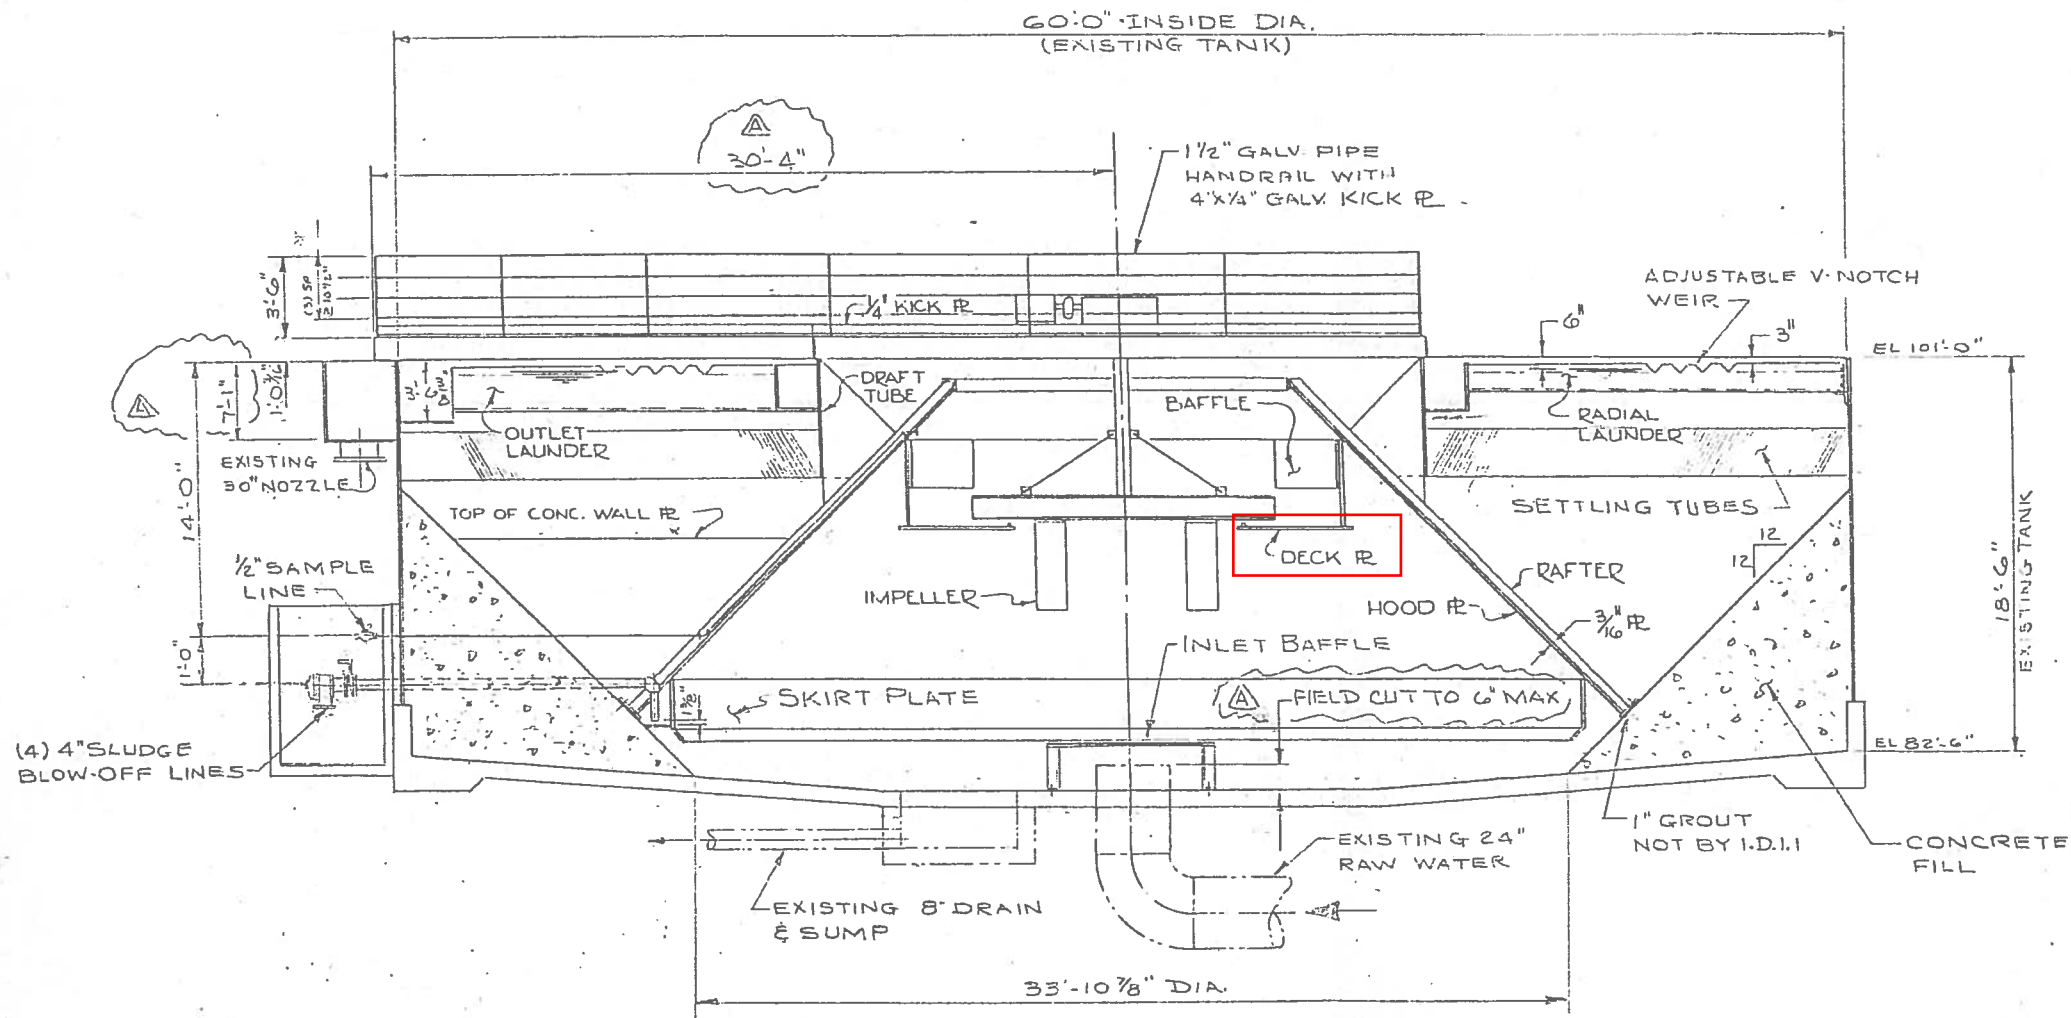

SECTIONAL ELEVATION FOR TRUE ORIENTATION SEE PLAN VIEW

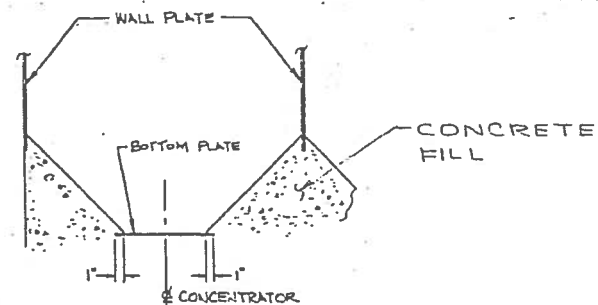

SECTION A-A DWG D90524-02-001

**Infilco Degremont Inc.**  
 Information Only - Return not required  
 Preliminary - Not to be used for construction  
 For Approval } Requests for changes can add to price and delay shipment  
 Certified

For **ALBANY WATER TREATMENT PLANT**  
**ALBANY, OR**  
 Civil Dwg No **56470-C**  
 Infilco Degremont Inc No **D90524**  
 Date **7/10/90** Rev No **101, 201, 301, 302**

REV. NO.	DR.	CHK.	APP.	DATE	ADDED DIMS.
DR	DRW			7/10	
CHK	EC Hager			7/10	
APP	EC Hager			7/10	
ASSEMBLY					SCALE
					N.T.S.
REFERENCE					D90524-02-002

**Infilco Degremont Inc**  
 Richmond Va.  
**ACCELERATOR, TYPE NS**  
**ELEVATION LAYOUT**  
**#22 Z**  
**D90524-02-002**